

OCEAN COUNTY HEALTH DEPARTMENT

P.O. BOX 2191

TOMS RIVER, N.J. 08754-2191

No. 025920

Date

(732) 341-9700

BOARD OF HEALTH OF Lakewood

CERTIFICATE OF COMPLIANCE

Issued to

Princ of Repair

(Owner or Contractor)

THIS IS TO CERTIFY That the

INDIVIDUAL SEWAGE SYSTEM

Approved

INDIVIDUAL WATER SYSTEM

N/A

Installed at Block No.

12.08

Lot No.

11

is in compliance with the

Application for Permit to Locate and Construct or

Alter Such Systems.

No.

025920

dated

2/8/02

The issuance of this certification shall not be construed as a guarantee that the system will function satisfactorily nor shall it in any way restrict the powers or responsibilities of the Board of Health in the enforcement of any law or ordinance relating to public health.

Final

[Signature]

OCEAN COUNTY HEALTH DEPARTMENT
P.O. Box 2191, Sunset Avenue
Toms River, NJ 08754-2191

APPLICATION FOR A PERMIT TO INSTALL A SEPTIC SYSTEM
AND/OR A WATER SUPPLY SYSTEM

Laurence G. Finan
Principal Registered Environ-
mental Health Specialist
Ocean County Health Department

Laurence G. Finan
OCEAN COUNTY
HEALTH DEPARTMENT

NOV 14 2009
PLAN APPROVED
DATE

Fee Paid

0259.00

Lakewood
MUNICIPALITY

Comm. Code 15
Official Use Only

Block 12.08

Lot(s) 11

- (A) To construct both a septic & water supply system
(B) To construct a water supply system
(C) To replace or alter a water supply system
(D) To construct or alter a septic system
(E) To replace or repair a septic system

Type of Water System

- (A) Potable Non-Public
(B) Potable Public Non-Community
(C) Non-Potable
(D) Public Community System

(Current address of applicant required. All information must be completed.)

NAME OF APPLICANT *Sergei Pavlov of Boks Septic, Inc.* PHONE NO. *732-370-0341*

ADDRESS *724 Valley Dr.* CITY *Lakewood* STATE *NJ* ZIP *08861*

DIRECTIONS TO LOCATION *off of Centertel Avenue.*

WELL APPLICATION

TYPE OF CASING: Material _____ Diameter _____ Grade _____ Thickness _____

TYPE AND METHODS OF SEALING JOINTS: Type _____ Method _____

METHOD OF INSTALLATION _____ If Rotary or Auger, size of hole _____

GROUTING MATERIAL _____ Depth & Method of grouting: Depth _____

Method _____

STORAGE TANK CAPACITY _____ Model No. _____

WELL DRILLER _____ Lic. # _____ Driller Phone # _____
(Print)

DRILLER _____ State Well Permit # _____
(Signature)

NOTE: Copy of NUDEP "Permit to Drill Well" must be attached. Hose bibs are prohibited on non-potable well, unless such well is sampled. NUDEP's "Well Record" must be immediately submitted to the Health Department upon installation of well.

SEPTIC APPLICATION

TYPE OF BUILDING TO BE SERVED *Business* Dwelling Unit: No. of Bedrooms _____

EXPANSION ATTIC, DEN OR REC. ROOM: Yes _____ No ☒ If yes, calculate as additional bedroom _____

PERCOLATION TEST PERFORMED BY _____ Date _____ Phone _____

WEATHER CONDITIONS AT TIME OF TEST _____


ENGINEER'S SIGNATURE AND SEAL _____

NOTE: All engineering data relating to soils, percolation & system design must be on engineer's drawing. Engineer's drawings must be signed & sealed by the engineer.

STATEMENT: Submit four (4) complete legible copies of applications, including engineer's & well driller's submissions. Final approval will only be granted after all inspections are completed, "as-built" drawings are submitted (where required) and satisfactory water analysis received, and all fees are paid. Permit is valid for one (1) year from date of issuance.

Stipulations
1. 24 hour notification

BACK
OF
House

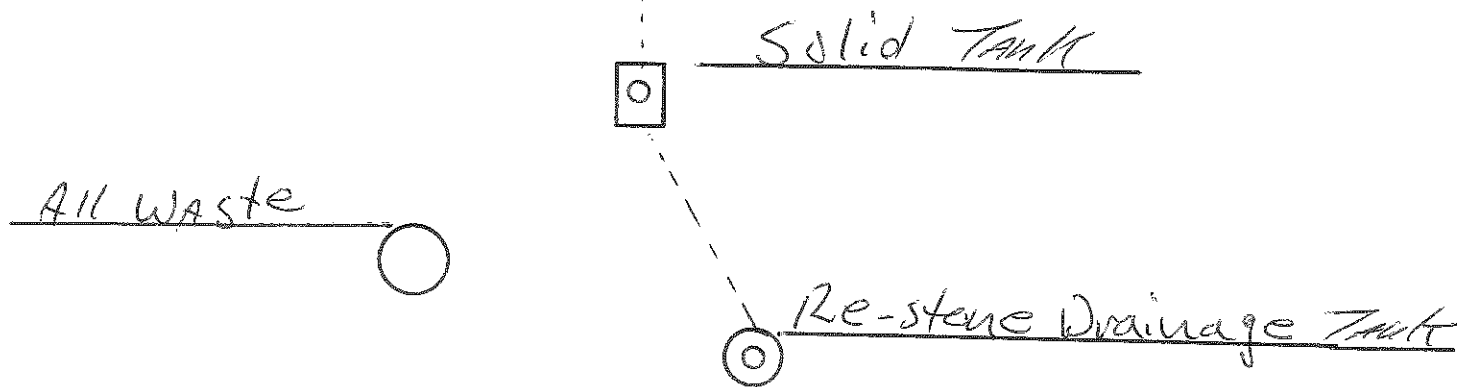

Mark Seigel

724 Valley Dr. Lakewood, N.J.

Block #12.08

LOT #11

Water-City

Bedrooms - 4

Replacing pipe from House to solid Tank with
Clean out. Re-stoning drainage Tank
All waste material to be buried on site

Wm. J. Conell