


NORTH

FILED MAP # L-3665

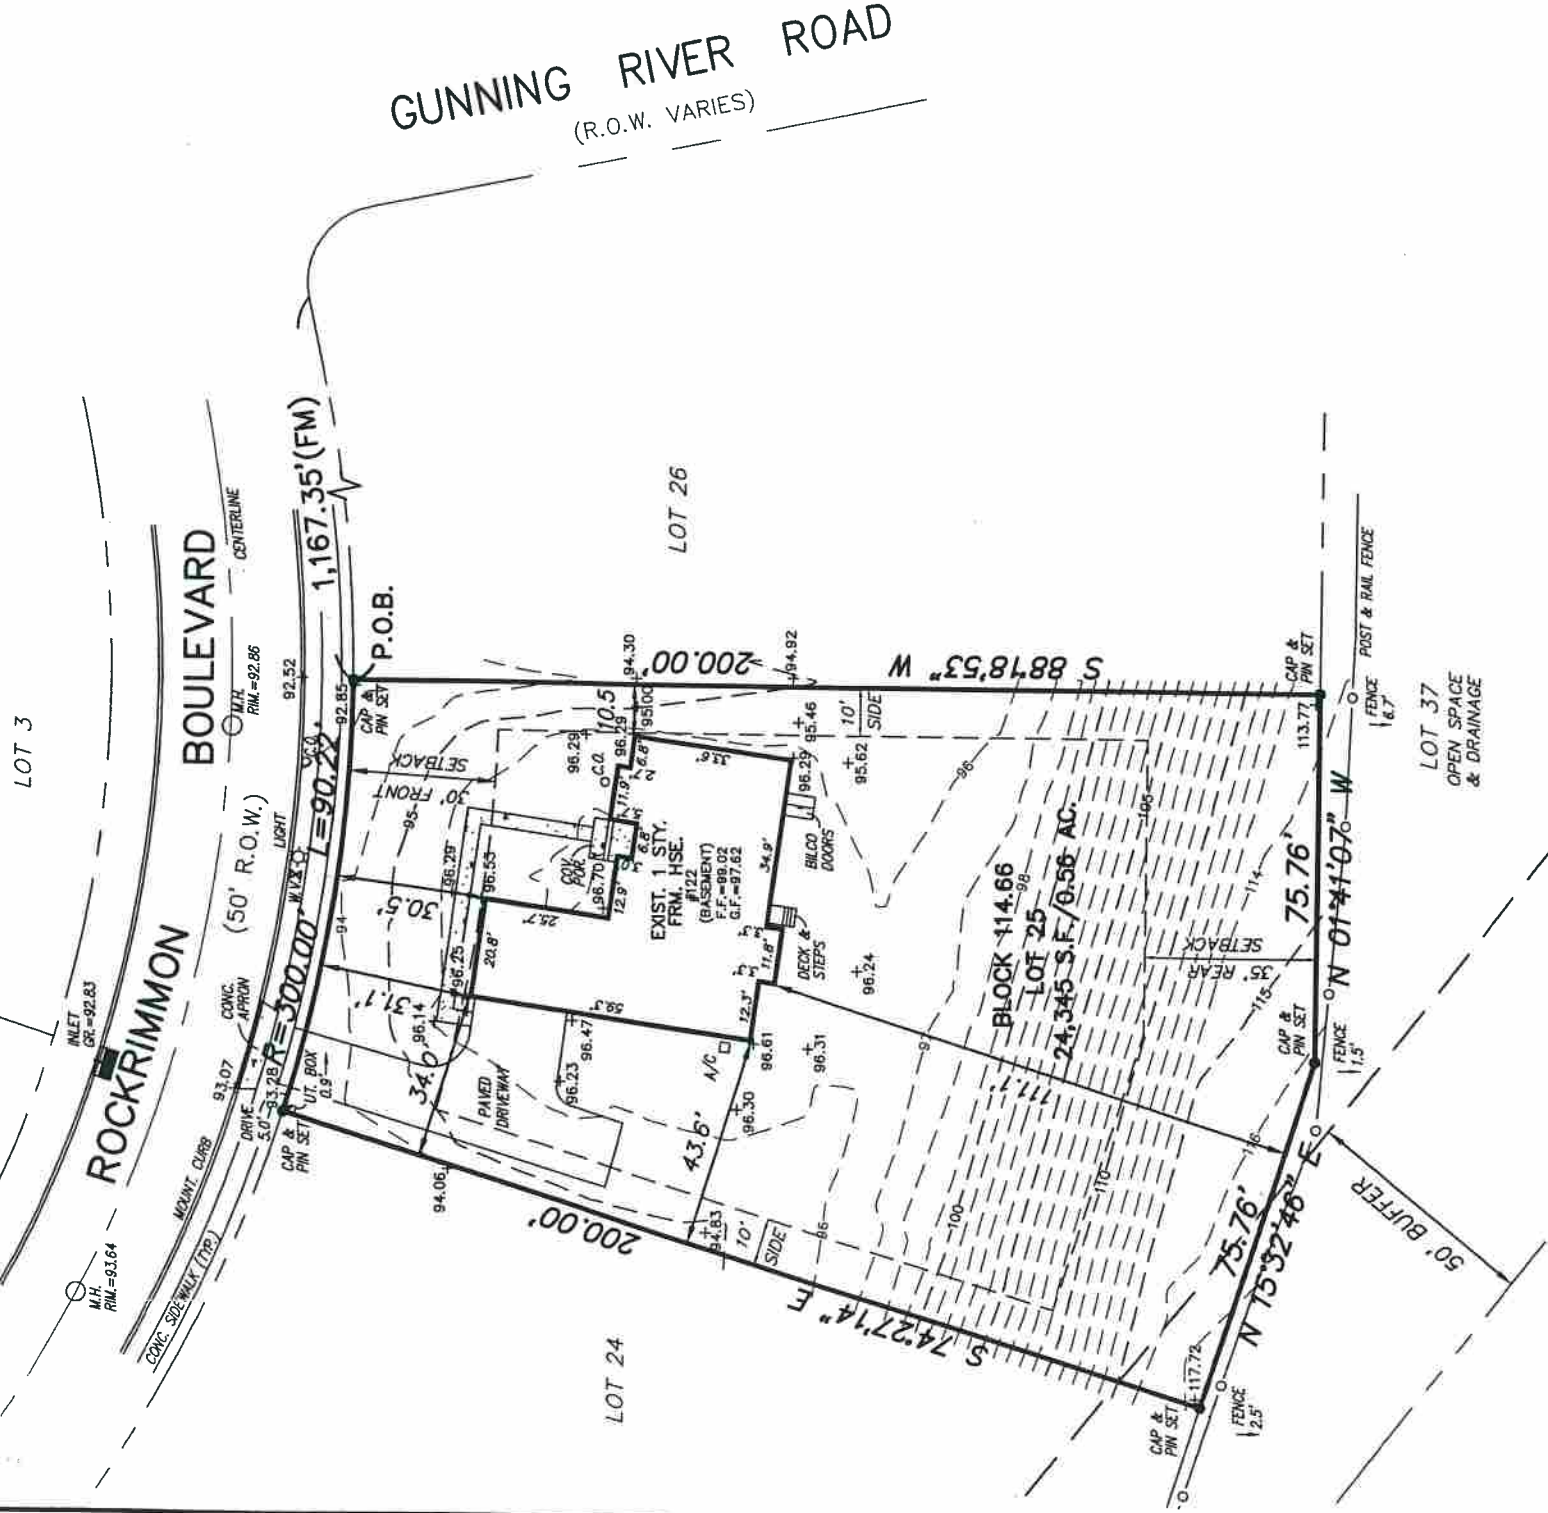

SURVEY NOTE:

1. THE SUBJECT PROPERTY IS LOCATED IN THE R-20 ZONE
2. ALL BUILDING TIES TO FOUNDATION

SURVEY FOR:

LEWIS A. LEVIN AND BARBARA A LEVIN H/W

A.K.A. TAX MAP LOT 25 ~ BLOCK 114.66

NO.	DATE	DESCRIPTION
2.	2/23/11	AS-BUILT SURVEY J.F.P.
1.	11/23/10	ADD FOUNDATION LOCATION C.E.S.
		BY