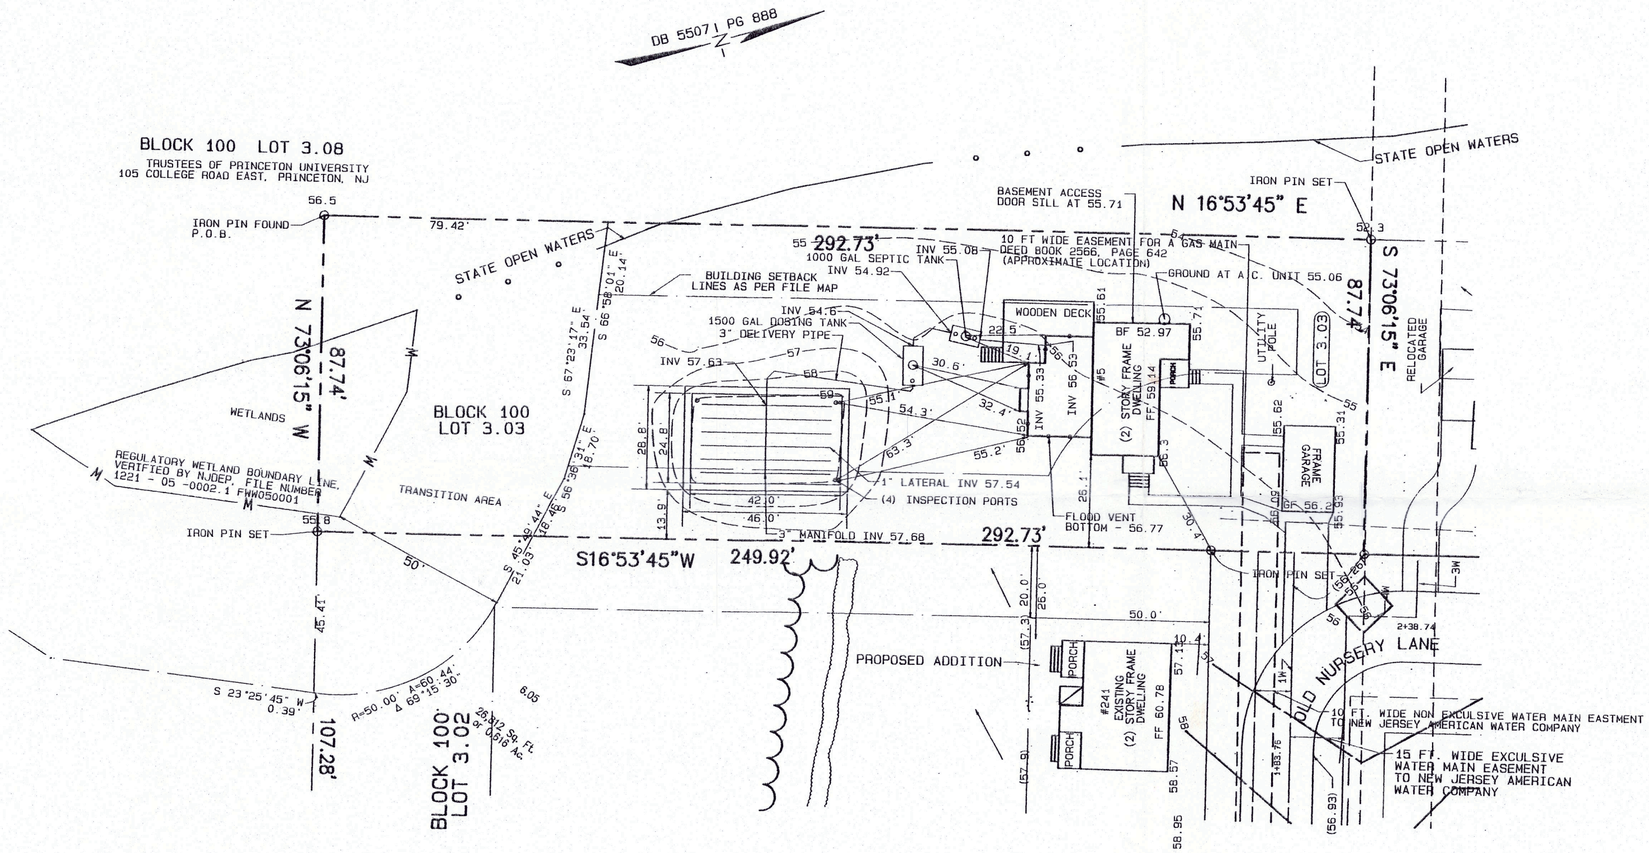

BOTTOM OF SELECT FILL IS AT ELEVATION 49.6

GRAPHIC SCALE 1"=30'

0 30 60 90

PROJECT	DWG. NUMBER :
BLOCK 100 LOT 3.03 5 OLD NURSERY LANE SOUTH BRUNSWICK TOWNSHIP, MIDDLESEX COUNTY, NJ	04069 ASB SSD 3.03

DWG. TITLE **SEPTIC SYSTEM ASBUILT PLAN**

OWNER & APPLICANT

BRIAN SASSMAN

DATE	SCALE	DRAWN BY:	CHECK BY:	FIELD BK
7/13/2009	1"=30'	DD	TD	142, DC

WILLIAM M. DORAN and SONS
PROFESSIONAL ENGINEERS, LAND SURVEYORS and PLANNERS

David Doran 7.13.09
DATE

WILLIAM M. DORAN, PE & PLS LIC. # 15082 PP LIC. # LI 04216
DANIEL M. DORAN, PE & PLS LIC. # 32389 PP LIC # LI 04427

14 NEWMAN ROAD, KENDALL PARK, NJ 08824 (732) 297 - 0112