Brick

Permit Without a Jacket

Permit Number A - 2851

Construction Permit # A-2851 April 24 79

19

Owner Macijauskas, Peter

Location 552 Penna. Ave.

Hollywood Manor

Block 1406-5 Lot 8-10

Contractor same

Fee $ 52.22 Use garage

BUILDING SUB-CODE INSPECTIONS **VIOLATIONS**

Footing Trench 5/16/79 JK

Slab

Foundation 5-31-79 JK

Framing

Insulation

Final 2-3-83 JK

C. O. Issued

PLUMBING SUB-CODE INSPECTIONS

Slab

Rough

Septic/Sewer

Water

Final

Electrical Final

Use reverse side for additional remarks

Callie

CONSTRUCTION PERMIT APPLICATION

BRICK TOWNSHIP, NEW JERSEY

APR 12 1979

BUILDING

IMPORTANT — Complete ALL items. Mark boxes where applicable

I. LOCATION OF BUILDING

Number and street: 552 PENNSYLVANIA AVE | Section: Hollywood Manor | Lot: 8-10 | Block: 1406-5

N S / E W side of ..... feet N S / E W from intersection of .....

(Other local geographic, political, or legal subdivision identification)

II. TYPE AND COST OF BUILDING — All applicants complete Parts A-D

458-3640

A. TYPE OF IMPROVEMENT

1 ☐ New buildings
2 ☐ Addition (If residential, enter number of new housing units added, if any, in Part D, 13)
3 ☐ Alteration (See 2 above)
4 ☐ Repair, replacement
5 ☐ Demolition
6 ☐ Moving (relocation)
7 ☒ Garage
☐ Swim Pool ☐ in ☐ out
☐ Fence

B. OWNERSHIP

8 ☐ Private (individual, corporation, nonprofit institution, etc.)
9 ☐ Public (Federal, State, or local government)

D. PROPOSED USE — For "Wrecking" most recent use

Residential

12 ☐ One family
13 ☐ Two or more family — Enter number of units .....
14 ☐ Transient hotel, motel, or dormitory — Enter number of units .....
15 ☒ Garage
16 ☐ Carport
17 ☐ Other — Specify .....

describe TWO CAR GARAGE

Nonresidential

18 ☐ Amusement, recreational
19 ☐ Church, other religious
20 ☐ Industrial
21 ☐ Parking garage
22 ☐ Service station, repair garage
23 ☐ Hospital, institutional
24 ☐ Office, bank, professional
25 ☐ Public utility
26 ☐ School, library, other educational
27 ☐ Stores, mercantile
28 ☐ Tanks, towers
29 ☐ Other - Specify .....

C. COST

	(Omit cents)
10. Cost of improvement	$ 1500
To be installed but not included in the above cost	
a. Electrical (# Fixtures, Outlets)	
b. Plumbing (# of Fixtures)	
c. Heating, air conditioning	
d. Other (elevator, etc.)	
11. TOTAL COST OF IMPROVEMENT	$ 1500

Nonresidential — Describe in detail proposed use of buildings, e.g., food processing plant, machine shop, laundry building at hospital, elementary school, secondary school, college, parochial school, parking garage for department store, rental office building, office building at industrial plant. If use of existing building is being changed, enter proposed use.

III. SELECTED CHARACTERISTICS OF BUILDING —

For new buildings and additions, complete Parts E-I; for wrecking, complete only Part H, for all others skip to IV.

E. PRINCIPAL TYPE OF FRAME

☐ Masonry (wall bearing)
☐ Wood frame
☐ Structural steel
☐ Reinforced concrete
☐ Other - Specify .....

F. TYPE OF HEATING SYSTEM

Specify .....

Air Cond. Yes ☐ No ☐

G. TYPE OF SEWERAGE DISPOSAL

☐ Public
☐ Individual

H. DIMENSIONS

Number of stories .....

Total square feet of floor area, all floors, based on exterior dimensions .....

Total land area, sq. ft. .....

I. RESIDENTIAL BUILDING ONLY

Number of bedrooms .....

Number of bathrooms { Full ..... Partial .....

FEE COMPUTATIONS

VOLUME OF BUILDING	6292
BUILDING SUB CODE	44.04
ELECTRICAL CODE	—
PLUMBING CODE	—
PLAN REVIEW	4.40
CERTIFICATE OF OCCUPANCY	—
STATE TRAINING FUND	3.78
CONSTRUCTION PERMIT FEE	52.22

WP

SEE REVERSE

A-2851 Cash

SUB CONTRACTORS

NAME	TRADE	ADDRESS	ZIP CODE	PHONE #
1.				
2.				
3.				
4.				
5.				
6.				
7.				
8.				

PERSON TO BE IN CHARGE OF CONSTRUCTION

NAME PETER MACIJAUSKAS

ADDRESS 552 PENNSYLVANIA AVE BRICKTOWN, NJ - 08723

IV. IDENTIFICATION — To be completed by all applicants

	Name	Mailing address — Number, street, city, and State	ZIP code	Tel. No.
1. Owner ~~Agent~~	PETER MACIJAUSKAS	552 PENNSYLVANIA AVE BRICKTOWN, N.J.	08723	458-3640
2. Contractor				
3. Architects				

The owner of this building and the undersigned agree to conform to all applicable laws of Township of Brick and that all required state, county and local prior approvals have been given. Owner

Signature of applicant	Address	Application date
P. Macijauskas	552 PENNSYLVANIA AVE	4/12/79

DO NOT WRITE IN THIS SPACE — FOR OFFICE USE ONLY

Approved by	Date permit issued	Permit Number
R. McKelvey	4/24/79	A-2851

I agree to construct said building in conformity with the plans and specifications filed with the Construction Official and in compliance with the provisions of the Building Code whether shown on plans or not.

BRICK TOWNSHIP APPLICANT'S DECLARATION

I PETER MACIJAUSKAS for the purpose of inducing the Inspector to accept the plans and specifications submitted by me and to issue a building permit, declare as follows:

I am the applicant named in, and who signed, the annexed application for a building permit to be issued by the Building Inspector of the Township of Brick in the County of Ocean, State of New Jersey, for the (construction) (alteration) of a building in said township.

As permitted by the statute the plans and specifications which accompany said application were prepared by me, as I am myself acting as the designer of said (building) (alteration) which is to be constructed by me for my own occupancy.

The above words, "to be constructed by me" as used in this declaration do not mean that I intend personally to do the work of (construction) (altering) said building, but means that I am the person undertaking the work as owner and principal; and as above stated, said (building) (alteration) is to be constructed for my own occupancy.

Sworn and subscribed to
before me this 11th day
of April 1979

P. Macijauskas
APPLICANT

R. McKelvey
BUILDING INSPECTOR

Date 4/12/79

Mary K. Smith
Notary Public of New Jersey

MARY K. SMITH
A NOTARY PUBLIC OF NEW JERSEY
MY COMMISSION EXPIRES JULY 30, 1981.

P. MacJanks

Approved
Date 4-12-29
Permit No. A 2851
Building Inspector
RMcKay

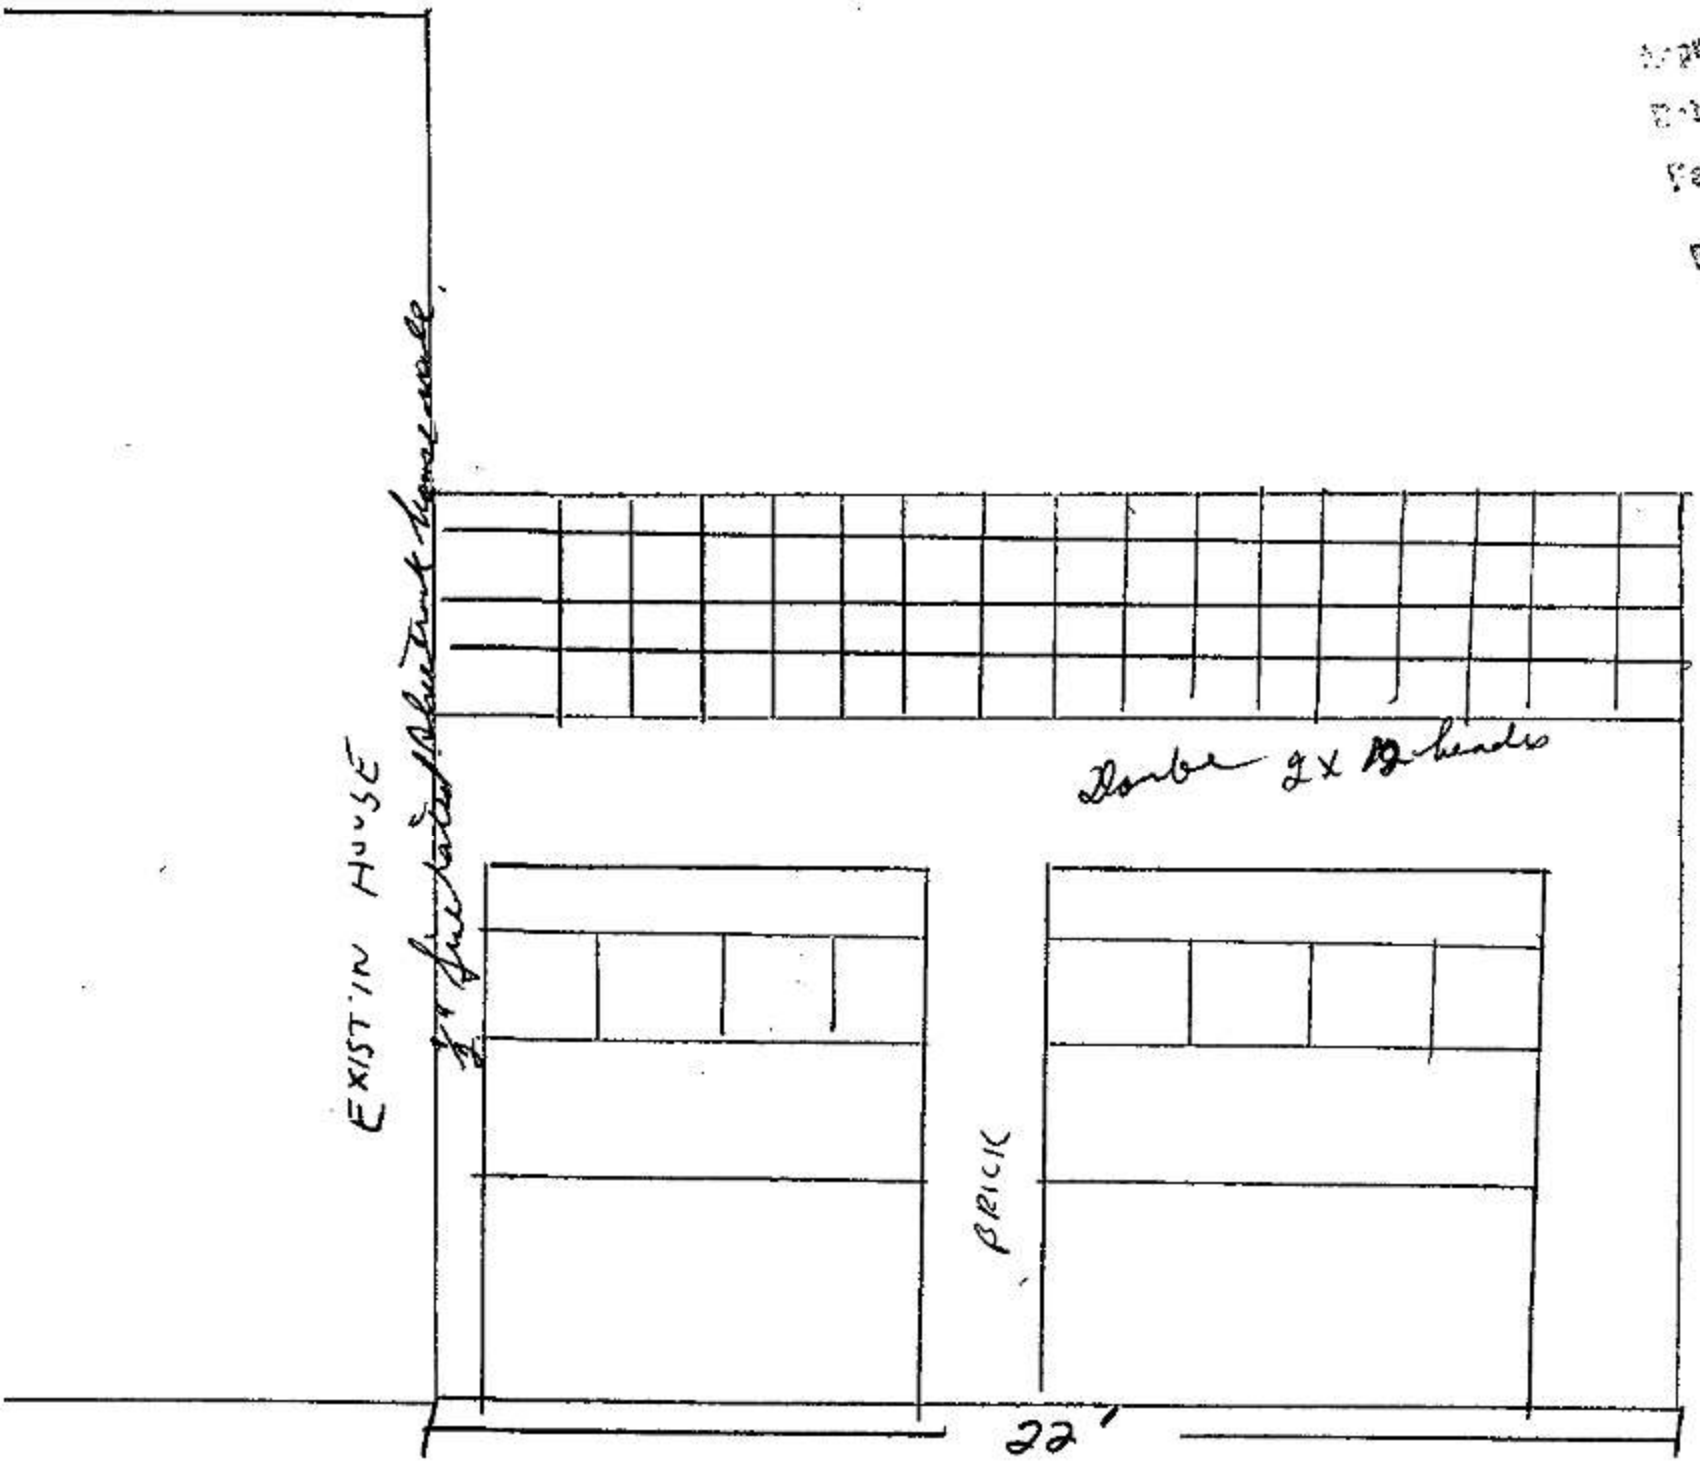

P. MacPherson

Approved
Date 4-12-79
Permit No. A-2851
Building Inspector
R Mackey

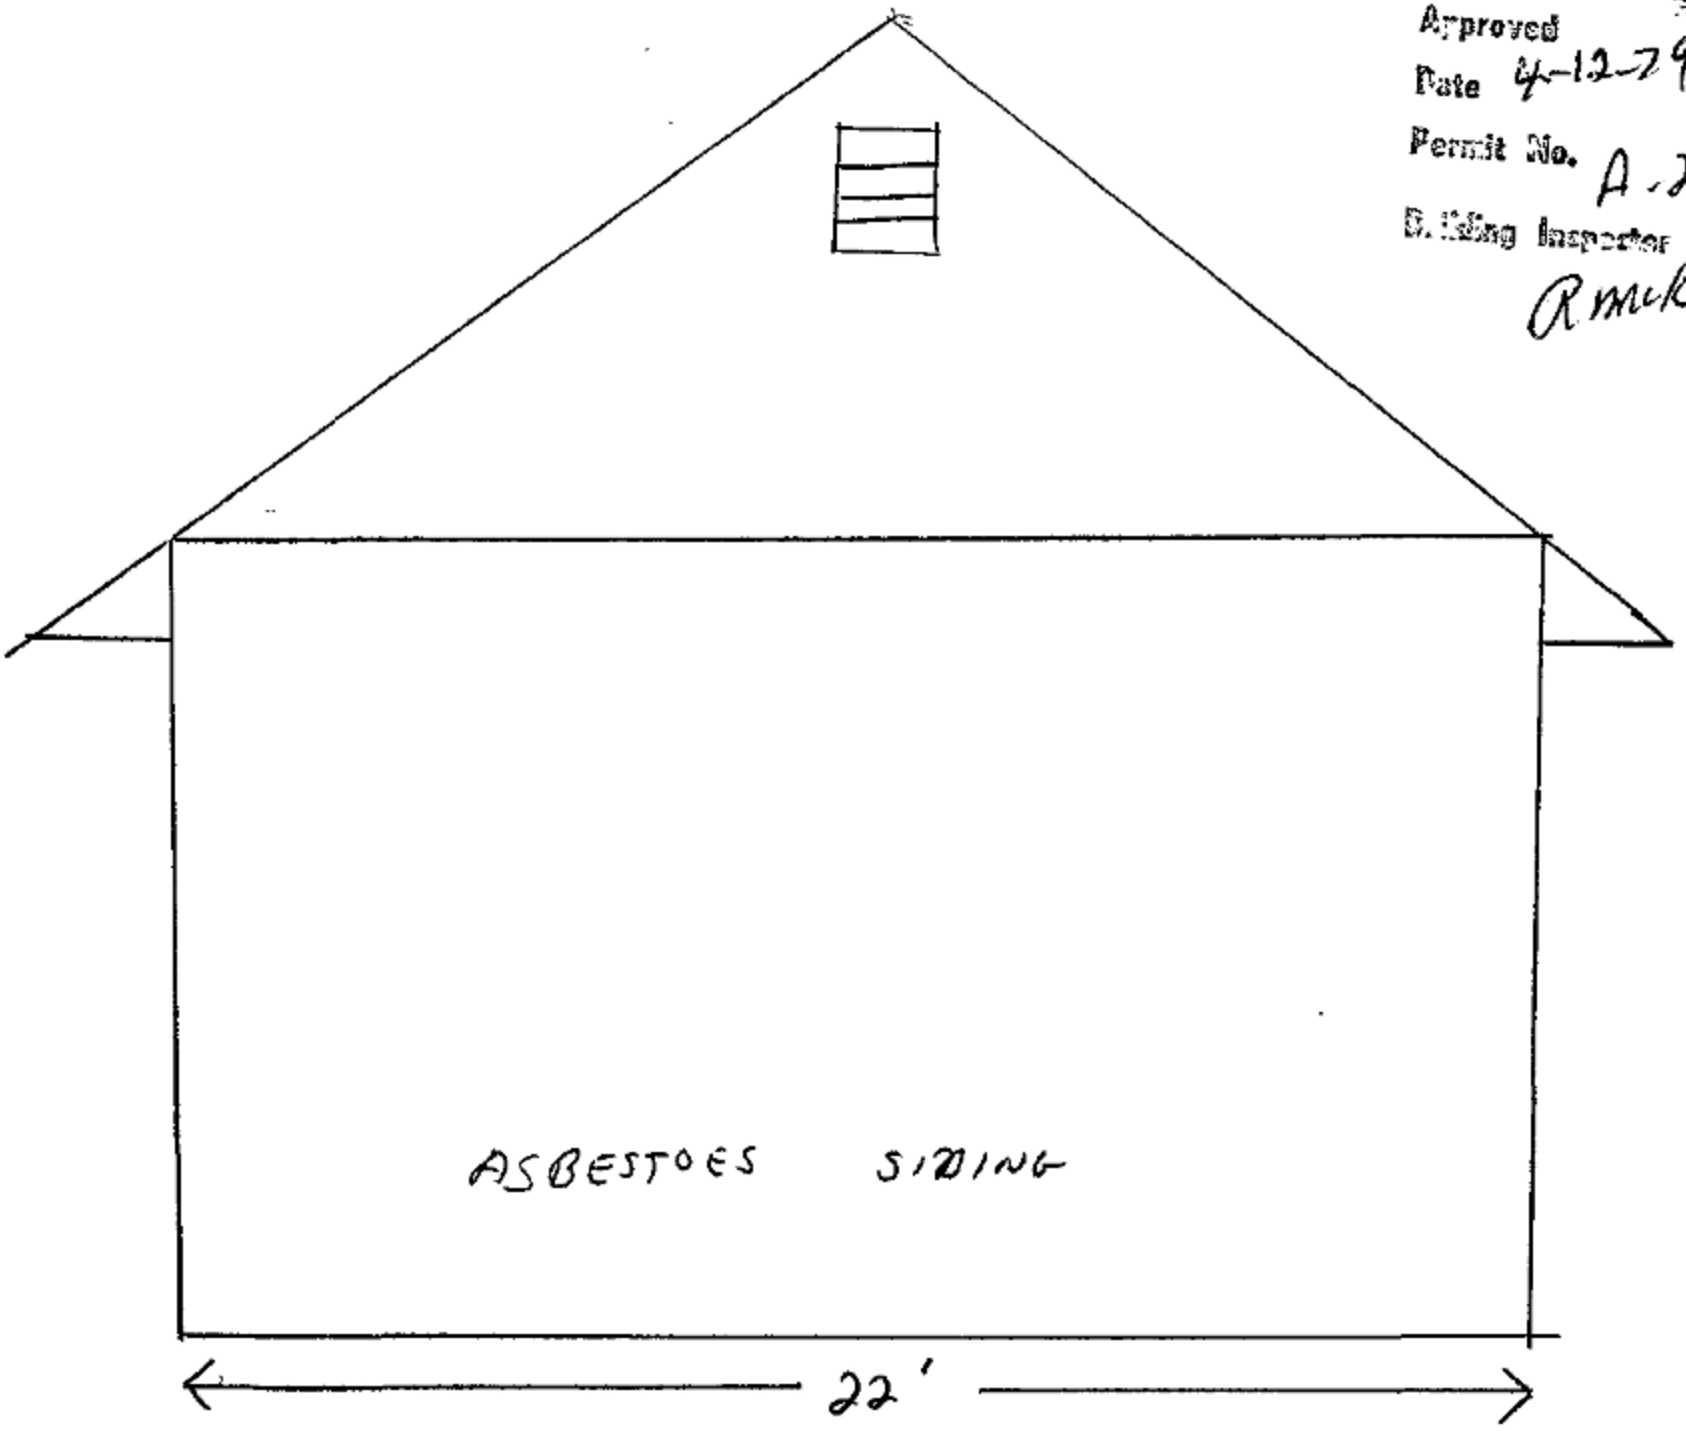


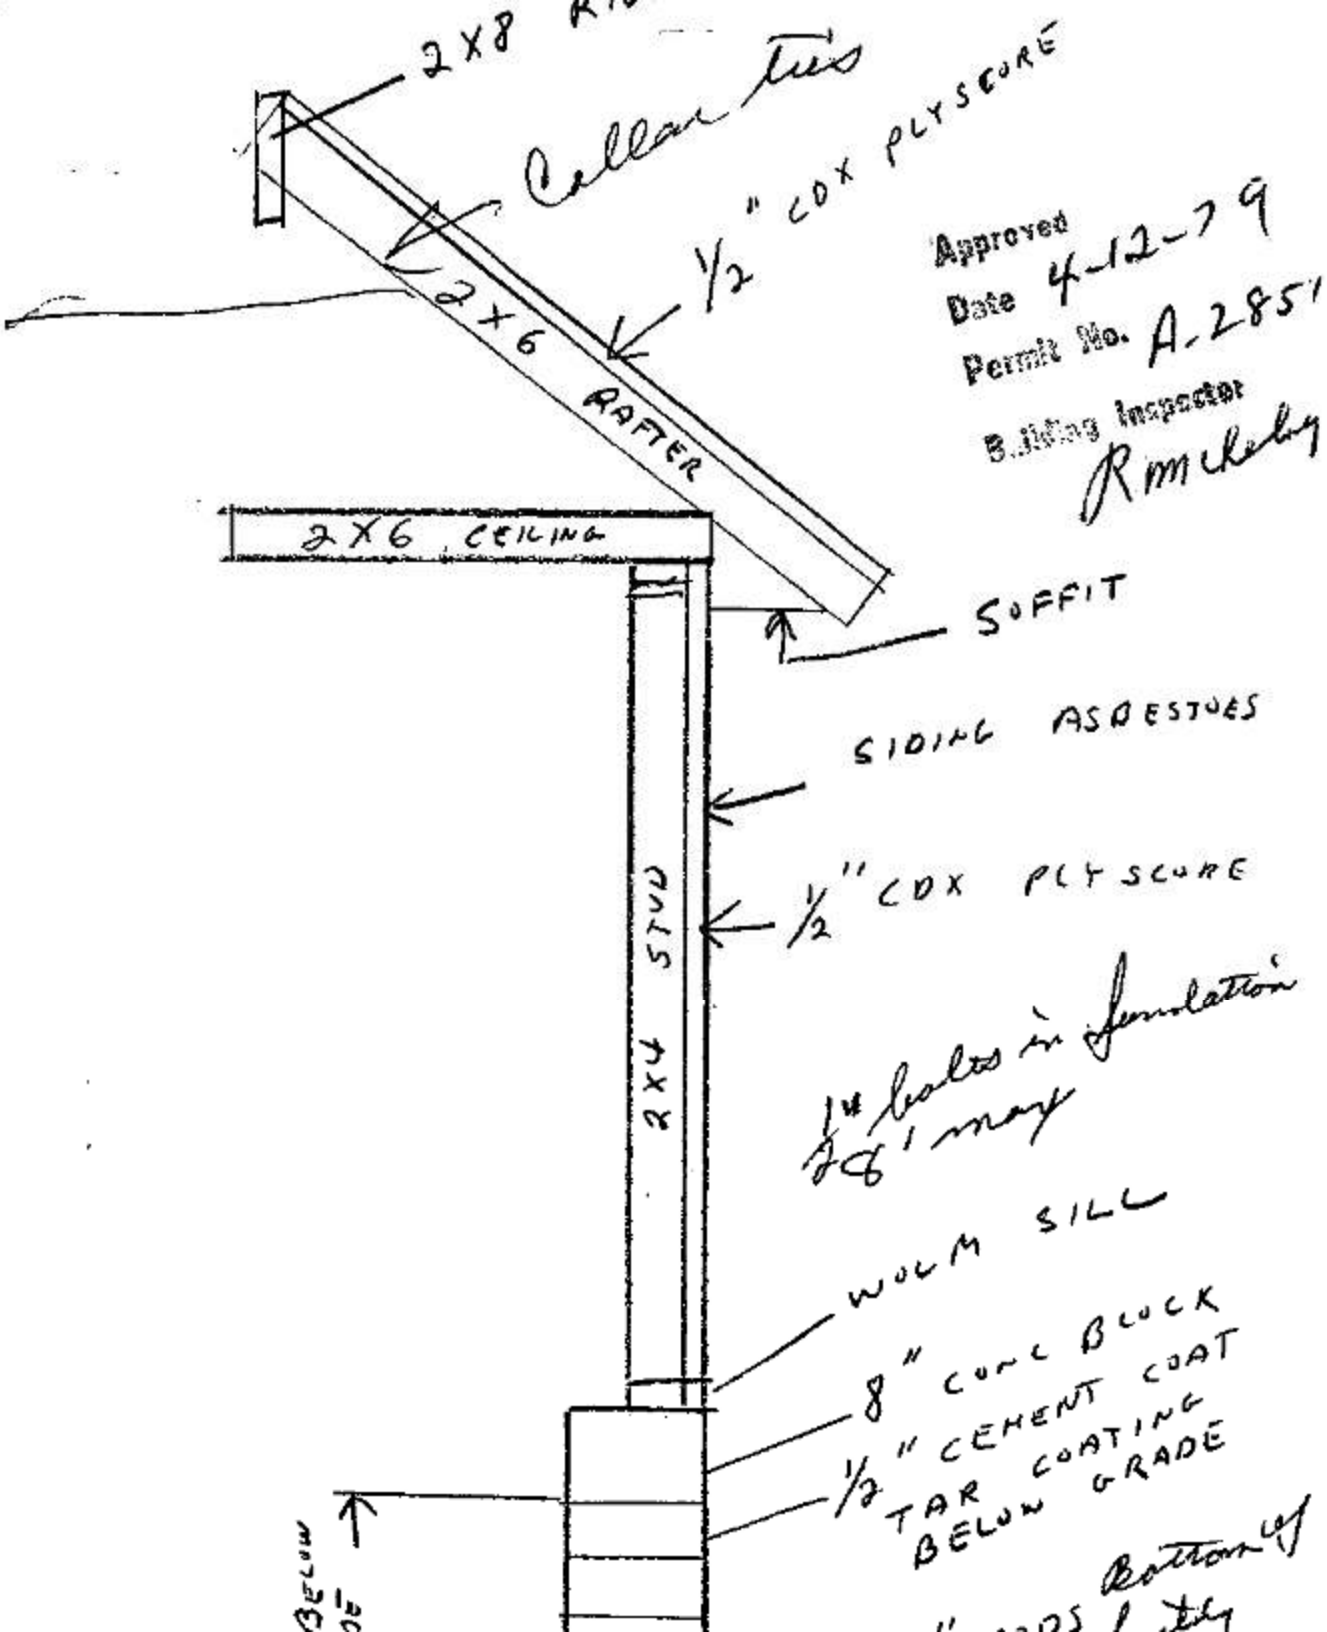

Approved
Date 4-12-79
Permit No. A-2851
Building Inspector
Rmckelvy

1" bolts in foundation
8' max

Bottom of

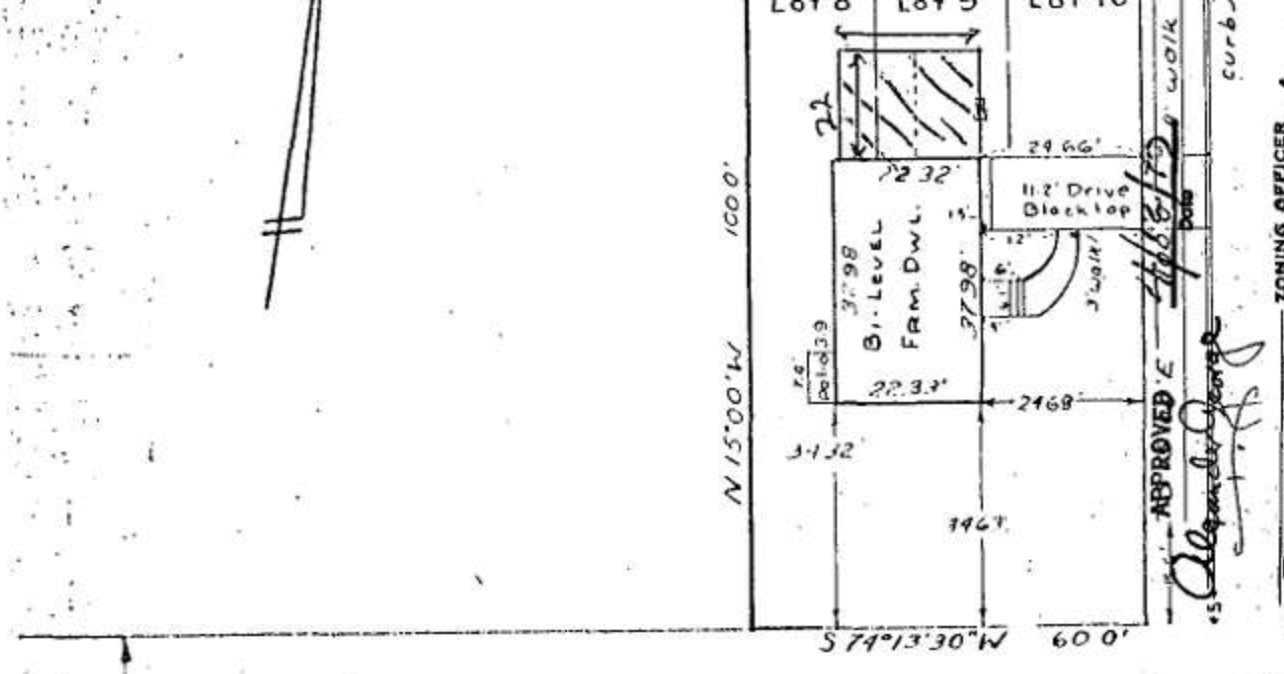

50' LANES MILL ROAD

SURVEY OF

LOTS - 8, 9, & 10 BLOCK - 5

HOLLYWOOD MANOR

BRICK TOWNSHIP OCEAN COUNTY, N. J.

Premises surveyed for Sherwood Park Inc. and certified to Henry Papenberg & Frances Papenberg, H/W, Dominick A. Mirabelli, Esq., South Jersey Mortgage Co., and to the Home Title Division of the Chicago Title Insurance Company.

Scale .1" = 30'

Cont. May 12, 1965
Nov. 27, 1964

ROBERT B. POWERS
Engineer & Surveyor
Chambers Bridge Road