BLOCK 902 LOT 8 ADDRESS (SITE) 500 Midstreams Rd. PERMIT NO. 2318-93

CONSTRUCTION PERMIT APPLICATION

Applicant Completes: Sections I, II, III (optional), IV, VI and VII

I. IDENTIFICATION

1. Proposed Work-site at: Midstreams School - 500 Midstreams Sch.
2. Name of Owner in Fee: Brick Board of Ed. Tel. (908) 477-2800
   Address 101 Hendrickson Av. (street) Brick (municipality) 08723 (zip code)
3. Ownership in Fee: Public ✓ Private ____
4. Principal Contractor: Ocean County Voc. Sch. Tel. (908) 920-0050
   Address 350 Chambersbridge Rd.
   License No. OR, if new home, Builder Reg. No. ____ Exp. Date ____
   Federal Emp. No. ____ Social Security No. ____
5. Architect or Engineer ____ Tel. ( ) ____
   Address ____
6. Responsible Person In Charge of Work ____ Tel. ( ) ____

V. FEE SUMMARY (for office use only)

		Update	Update
1. Building	$ 8 —		
2. Electrical			
3. Plumbing			
4. Fire Protection			
5. Other ____			
6. Subtotal	$		
7. Less 20% for State Plan Review			
8. Subtotal	$		
9. DCA Training Fee			
10. Subtotal	$		
11. Cert. of Occupancy			
12. Other ____			
13. TOTAL	$		

VI. BUILDING/SITE CHARACTERISTICS

	(office use only)
1. Number of Stories ____	
2. Height of Structure ____ ft.	
3. Area—Largest Floor ____ sq. ft.	
4. Building Area—All Floors ____ sq. ft.	
5. Volume of Structure ____ cu. ft.	
6. Construction Classification ____	
7. Total Land Area Disturbed ____ sq. ft.	
8. Flood Hazard Zone ____	
9. Base Flood Elevation ____ ft.	
10. Wetlands yes ____ sq. ft. / no ____	
11. Fire Grading ____	
12. Max. Live Load ____	
13. Max. Occupancy Load ____	

II. PROPOSED WORK

	Est. Cost
1. ☐ Minor Work (single trade)	
2. ☐ Small Job ($5,000 and no prior approvals)	
3. ☐ New Building	
4. ☐ Addition	
5. ☐ Alteration	
6. ☐ Fire Protection	
7. ☐ Plumbing	
8. ☐ Electrical	
9. ☐ Asbestos Abatement	
10. ☐ Demolition	
TOTAL COSTS ✓	$ 600

Shed

OPTIONAL (for office use only)

Plans Rec'd By	Date Rec'd	Rejection Date	Approval Date	Re-viewer	Resubmission Dates Approval	Rejection	Re-viewer
			9/28/93				
Eng	9/24/93	EWA					

III. DO YOU WANT: (optional) 1. ☐ Partial Releases 2. ☐ Prototype Processing

IV. DOES OR WILL YOUR BUILDING CONTAIN ANY OF THE FOLLOWING?

1. ☐ Elevators/Escalators/Lifts/Dumbwaiters/Moving Walks
2. ☐ High Pressure Boilers
3. ☐ Pressure Vessels
4. ☐ Refrigeration Systems
5. ☐ Cross-Connections/Backflow Preventers
6. ☐ Hazardous Uses/Places of Assembly
7. ☐ Sprinklers
8. ☐ Smoke Control Systems in Open Wells
9. ☐ Underground Storage Tanks

VII. DESCRIPTION OF BUILDING USE

A. RESIDENTIAL-
1. ☐ Hotels (R-1)
2. ☐ Multi-Family (R-2)
3. ☐ Two-Family (R-3) BOCA
4. ☐ Two-Family (R-4) CABO
5. ☐ One-Family (R-3) BOCA
6. ☐ One-Family (R-4) CABO

No of dwelling units:
Before Construction ____
After Construction ____
Net gain or loss ____

B. NON-RESIDENTIAL
1. State Specific Use: School
2. Use Group:
3. Change in Use Group, Indicate Former:

N/A

LDS BR 10313516

CERTIFICATION IN LIEU OF OATH

I. OWNER SECTION (to be completed if the applicant is the owner in fee)

I hereby certify that I am the owner in fee of the property listed on Page 1.

Mark the following applicable boxes:

A. ( ) I further certify that a new home (private residence) will be constructed on this property for my own use and occupancy. This dwelling is to be occupied by myself and is not to be used for any purpose other than single family residential use. I attest that all construction, plumbing, or electrical work will be done, in whole or in part, by me or by subcontractors under my supervision, in accordance with all applicable laws; and, I further acknowledge that said new home is not covered under the New Home Warranty and Builders Registration Act (N.J.S.A. 46:3B-1 et seq.) and that such fact shall be disclosed to any person purchasing this property within ten years of the date of issuance of a certificate of occupancy.

I UNDERSTAND THAT IN MARKING BOX A, I ACKNOWLEDGE THAT I AM ASSUMING RESPONSIBILITY FOR THE WORK DONE ON SAID PROPERTY, THE CONDITION OF THE PROPERTY PRIOR TO, DURING, AND AFTER ANY WORK PERFORMED, AND FOR THE PERFORMANCE OF THE SUBCONTRACTORS I HIRE, EMPLOY, OR OTHERWISE CONTRACT OR WITH WHOM I MAKE AGREEMENTS TO PERFORM WORK. I AM VOLUNTARILY AND KNOWINGLY ASSUMING THIS RESPONSIBILITY.

B. ( )I further certify the following as required by the New Jersey Uniform Construction Code, N.J.A.C. 5:23-2.15(e)1.vii:

I personally prepared the plans submitted for: 1) the new home referred to in A.; or, 2) an addition, alteration, renovation, or repair to an existing single family residence owned and occupied by myself and located on the property listed on Page 1; or, 3) a new structure that will be physically separate from, but that will be deemed part of, an existing single family residence that is owned and occupied by myself and located on the property listed on Page 1.

C. ( ) I further certify that I will perform or supervise the following work:
C.1. ( ) Building C.2. ( ) Fire Protection
I further certify that I will perform the following work:
C.3. ( ) Electrical C.4. ( ) Plumbing

D. ( )I agree to advise all contractors on this project that they are required to be registered with the New Jersey Division of Taxation and to comply with all New Jersey tax laws.

I further certify the following as required by the Uniform Construction Code, N.J.A.C. 5:23-2.15(a)5: All required State, county, and local prior approvals have been given, including such certification as the construction official may require.

I understand that if any of the above statements are willfully false, I am subject to punishment.

X Signature _____ Date _____

II. AGENT SECTION

(to be completed if the applicant is not the owner in fee)

I hereby certify the following as required by the New Jersey Uniform Construction Code, N.J.A.C. 5:32-2.15(d): the proposed work is authorized by the owner in fee; and I have been authorized by the owner in fee to make this application as his agent.

I further certify the following as required by the Uniform Construction Code, N.J.A.C. 5:23-2.15(a)5: All required State, county, and local prior approvals have been given, including such certification as the construction official may require.

I agree to advise all contractors on this project that they are required to be registered with the New Jersey Division of Taxation and to comply with all New Jersey tax laws.

I understand that if any of the above statements are willfully false, I am subject to punishment.

( ) Check if contractor.

X Agent Name _____

Address _____

_____

Telephone (____) _____

Signature _____ Date _____

OFFICE DATE RECEIVED: _____

VIII. PRIOR APPROVALS CHECKLIST (office use only)	LOCAL APPROVAL Prelimin. Initial	LOCAL APPROVAL Final Date	COUNTY APPROVAL Prelimin. Initial	COUNTY APPROVAL Final Date	REGIONAL APPROVAL Prelimin. Initial	REGIONAL APPROVAL Final Date	STATE APPROVAL Prelimin. Initial	STATE APPROVAL Final Date
☐ Planning Board							X	X
☐ Zoning Board			X	X	X	X	X	X
☐ Sewer Authority							X	X
☐ Water Authority							X	X
☐ Fire Department					X	X	X	X
☐ Police Department			X	X	X	X	X	X
☐ Health Department					X	X		
☐ Soil Conservation							X	X
☐ N.J. Dept. of Community Affairs	X	X	X	X	X	X		
☐ N.J. Department of Transportation	X	X	X	X	X	X		
☐ N.J. Dept. of Environmental Protect.	X	X	X	X	X	X		
☐ Utility Dig No.			X	X	X	X	X	X
☐ Other								
☐								
☐								

COMMENTS

4-29-43 MP

IMPORTANT
A.H.B.T. EXEMPT

IX. SUBCODES AND SPECIAL REGULATIONS APPLICABLE (office use only—optional)

Name of Code & Edition		Name of Code & Edition			
Building		Energy		Other	
Electrical		Barrier Free			
Plumbing		Flood Hazard			
Fire Protection		As Built Elevation Cert.			
Mechanical		Other			

X. CERTIFICATES ISSUED (office use only)

			DATE EXPIRED
☐ Temporary Certificate of Occupancy	No.		
☐ Temporary Certificate of Occupancy	No.		
☐ Continued Certificate of Occupancy	No.		
☐ Certificate of Occupancy	No.		
☐ Certificate of Approval	No.		
☐ None			

NEW JERSEY UNIFORM CONSTRUCTION CODE

CONSTRUCTION PERMIT

Date Issued 9/29/93
Control #
Permit # 2318-93

IDENTIFICATION Block 902 Lot 8

Work Site Location 5?07 Midstream Rd

Owner in Fee Brick Bd of Ed

Address 101 Hendrickson Ave

Tele. ( ) Brick

Contractor J. C Van Schaaf

Address

Tele. ( )

Lic. No. or Bldrs. Reg. No. Exp. Date

Federal Emp. No.

or Social Security No.

is hereby granted permission to perform the following work:

[✓] BUILDING [ ] PLUMBING [ ] OTHER
[ ] ELECTRICAL [ ] FIRE PROTECTION

DESCRIPTION OF WORK:

Shed

PAYMENTS (Office Use Only)	
Building	
Plumbing	
Electrical	
Fire Protection	
Other	
Other	
DCA Training Fee	
Cert. of Occ.	
Other	
Total	
Check No.	
Cash	
Collected By:	

NOTE: If construction does not commence within one (1) year of date of issuance, or if construction ceases for a period of six (6) months, this permit is void.

Estimated Cost of Work $ 60—

CONSTRUCTION OFFICIAL

U.C.C. Form F-170A

1 WHITE - OFFICE 2 CANARY - TAX ASSESSER 3 PINK - JACKET 4 GOLD - APPLICANT

BUILDING SUBCODE TECHNICAL SECTION

Date Received 9/29/93
Date Issued 13
Control #
Permit # 2318-93

A. IDENTIFICATION—APPLICANT: COMPLETE ALL APPLICABLE INFORMATION. WHEN CHANGING CONTRACTORS. NOTIFY THIS OFFICE. CALL UTILITY DIG NO: 1-800-272-1000.

Block 902 Lot 8
Work Site Location Midstreams School

Owner in Fee Brick Board of Education
Address 101 Hendrickson Ave. Brick

Tele. ( )
Contractor Ocean County Vocational School
Address 350 Chambersbridge Rd.

Tele (908) 920-0050
Lic. No. or Bldrs. Reg. No.
Federal Emp. No. or Social Security No.

C. CERTIFICATION IN LIEU OF OATH

I hereby certify that I am the (agent of) owner of record and am authorized to make this application.

Signature

D. TECHNICAL SITE DATA

DESCRIPTION OF WORK

Move location of Shed from O.C Voc to Midstreams School.

JOB SUMMARY (Office Use Only)

PLAN REVIEW	Date	Initial
[ ] No Plans Req.		
[✓] All	9/29/93	
[ ] Footing		
[ ] Foundation		
[ ] Frame		
[ ] Other		

Joint Plan Review Required:
[ ] Elec. [ ] Plumb. [ ] Fire

SUBCODE APPROVAL
[ ] CO [ ] CCO [ ] CA

Date.
Approved By:

INSPECTIONS Type:	Dates (Month/Day) Failure	Failure	Approval	Initial
Footing				
Foundation				
Slab				
Frame				
Insulation				
Finishes:				
Energy				
Mechanical				
TCO				
Other				
Final				

B. BUILDING CHARACTERISTICS

Use Group Present Proposed
Constr. Class Present Proposed
No. of Stories
Height of Structure Ft.
Area—Largest Floor Sq. Ft.
Total Bldg. Area/All Floors Sq. Ft.
Volume of Structure Cu. Ft.
Total Land Area Disturbed Sq. Ft.

Est. Cost of Bldg. Work:
1. New Bldg. $
2. Alteration $
3. Total (1+2) $

TYPE OF WORK:
[ ] New Building
[ ] Addition
[ ] Alteration
  [ ] Roofing
  [ ] Siding
  [ ] Other
[ ] Demolition
[ ] Miscellaneous
  [ ] Fence Height
  [ ] Sign Sq. Ft.
  [ ] Pool
  [ ] Elevator
  [ ] Asbestos Abatement
  [ ] Other

(Office Use Only)

FEE $

Administrative Surcharge $
Paid [ ] Check # Minimum Fee $
Collected by: TOTAL FEE $

U.C.C. Form F-110A
1 White = Inspector Copy
2 Canary = Office Copy
3 Pink = Office Copy
4 Gold = Applicant Copy

BUILDING SUBCODE TECHNICAL SECTION

Date Received 9/29/93
Date Issued
Control #
Permit # 2318-93

A. IDENTIFICATION—APPLICANT: COMPLETE ALL APPLICABLE INFORMATION. WHEN CHANGING CONTRACTORS, NOTIFY THIS OFFICE. CALL UTILITY DIG NO: 1-800-272-1000.

Block 902 Lot 8
Work Site Location Midstreams School

Owner in Fee Brick Board of Education
Address 101 Hendrickson Ave. Brick

Tele. ( )
Contractor Ocean County Vocational School
Address 350 Chambersbridge Rd.

Tele (908) 920-0050
Lic. No. or Bldrs. Reg. No.
Federal Emp. No. or Social Security No.

C. CERTIFICATION *IN LIEU* OF OATH

I hereby certify that I am the (agent of) owner of record and am authorized to make this application.

Signature

D. TECHNICAL SITE DATA

DESCRIPTION OF WORK

Move location of shed from O.C. Voc to Midstreams School.

JOB SUMMARY (Office Use Only)

PLAN REVIEW	Date	Initial
[ ] No Plans Req.		
[✓] All	9/	
[ ] Footing		
[ ] Foundation		
[ ] Frame		
[ ] Other		

Joint Plan Review Required:
[ ] Elec. [ ] Plumb. [ ] Fire

SUBCODE APPROVAL
[ ] CO [ ] CCO [ ] CA
Date.
Approved By:

INSPECTIONS Type:	Dates (Month/Day) Failure	Failure	Approval	Initial
Footing				
Foundation				
Slab				
Frame				
Insulation				
Finishes:				
Energy				
Mechanical				
TCO				
Other				
Final				

B. BUILDING CHARACTERISTICS

Use Group Present Proposed
Constr. Class Present Proposed
No. of Stories
Height of Structure Ft.
Area—Largest Floor Sq. Ft.
Total Bldg. Area/All Floors Sq. Ft.
Volume of Structure Cu. Ft.
Total Land Area Disturbed Sq. Ft.

Est. Cost of Bldg. Work:
1. New Bldg. $
2. Alteration $
3. Total (1+2) $

TYPE OF WORK:
[ ] New Building
[ ] Addition
[ ] Alteration
  [ ] Roofing
  [ ] Siding
  [ ] Other
[ ] Demolition
[ ] Miscellaneous
  [ ] Fence Height
  [ ] Sign Sq. Ft.
  [ ] Pool
  [ ] Elevator
  [ ] Asbestos Abatement
  [ ] Other

(Office Use Only)
FEE $

Administrative Surcharge $
Paid [ ] Check # Minimum Fee $
Collected by: TOTAL FEE $

U.C.C. Form F-110A
1 White = Inspector Copy
2 Canary = Office Copy
3 Pink = Office Copy
4 Gold = Applicant Copy

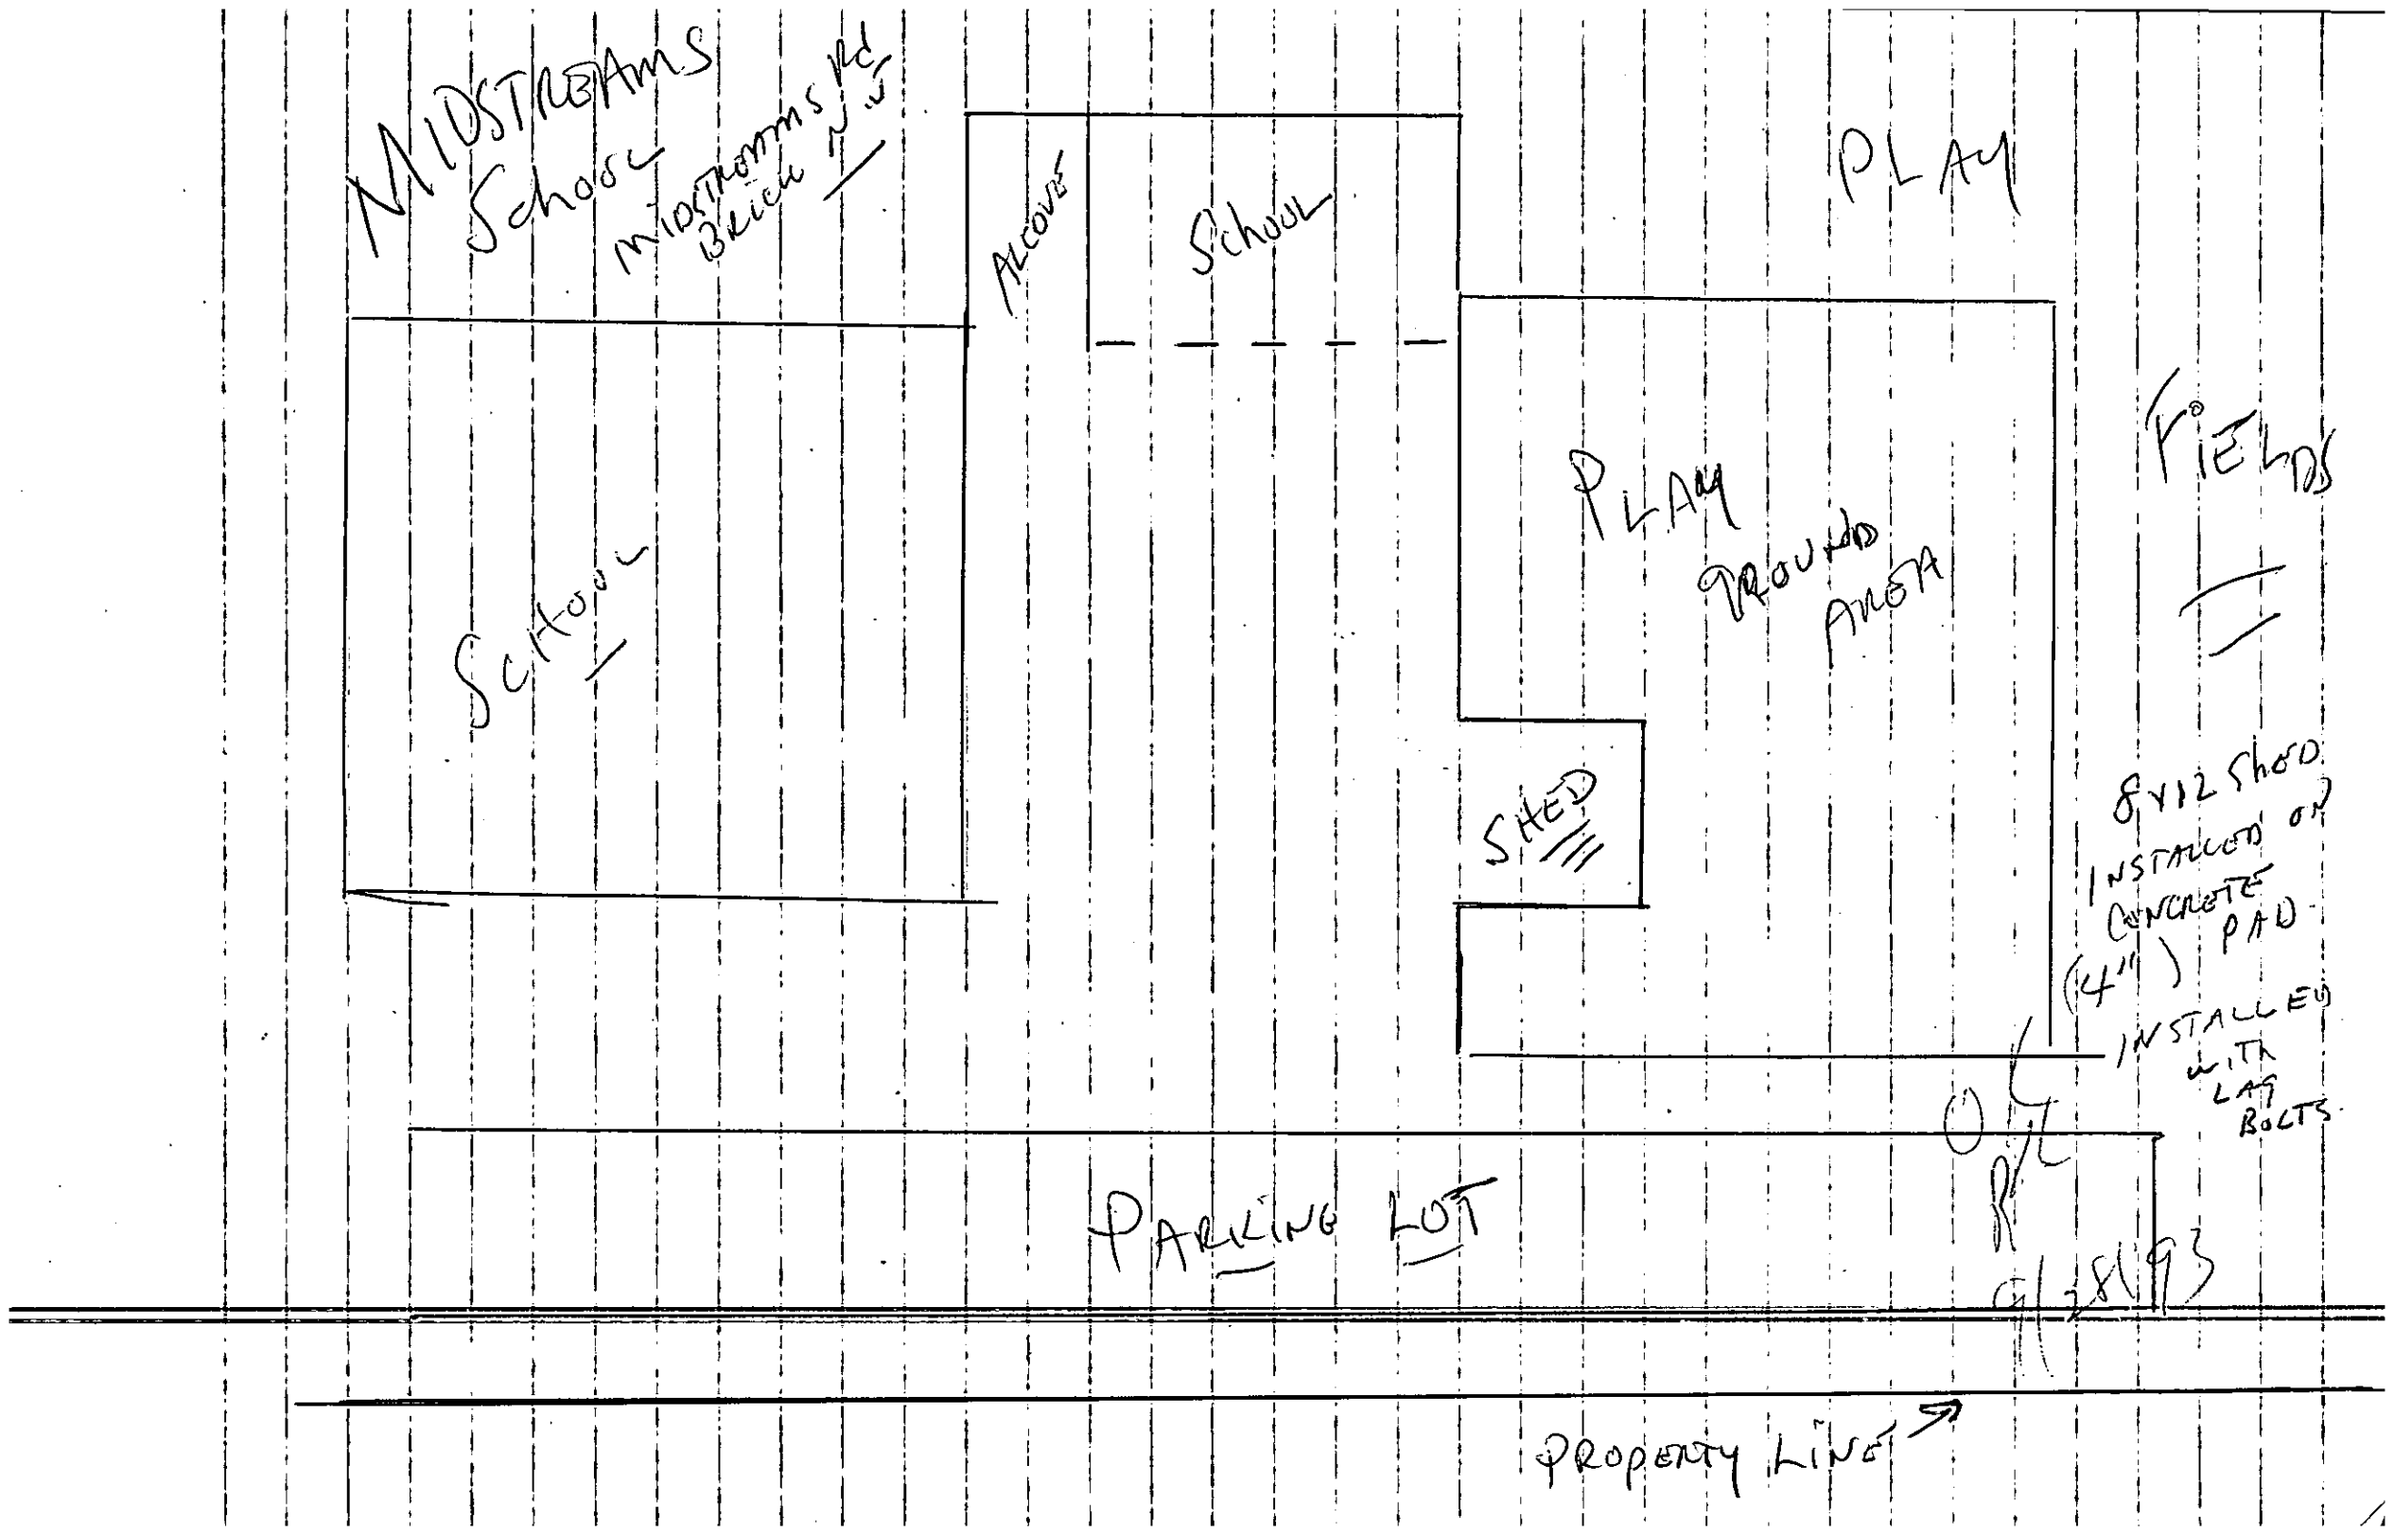
MIDSTREAMS
School
MIDSTREAMS RD.
BLICK N.J.
ALCOVE
School
School
PLAY
PLAY
GROUND
AREA
FIELDS
SHED
8'X12' SHED
INSTALLED ON
CONCRETE
(4") PAD
INSTALLED
WITH
LAG
BOLTS
PARKING LOT
PROPERTY LINE

ANCHORING METHOD
(ALL 4 CORNERS)

SHED IS ANCHORED TO EARTH BY A VERTICAL P.T. 2x4, LAG BOLTED TO THE FLOOR FRAMING HEADER & BURRIED IN A HOLE 32" DEEP W/ AN 8" CONCRETE FOOTING

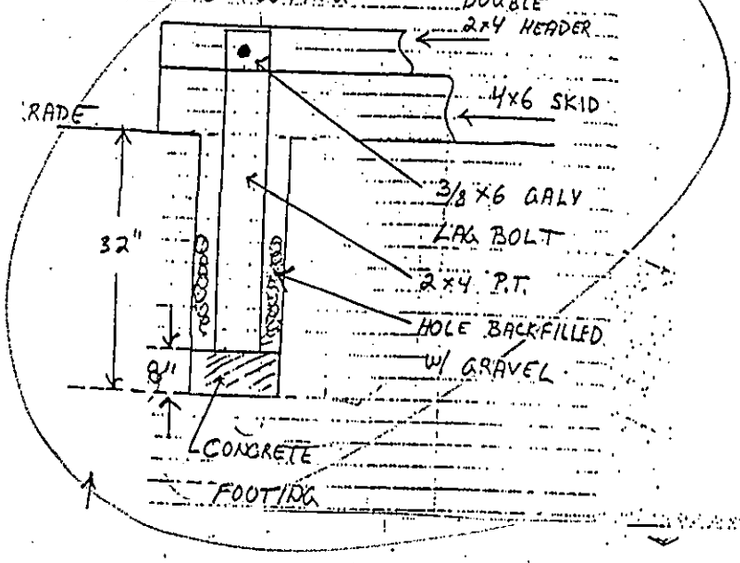

SHED ISOMETRIC

No scale

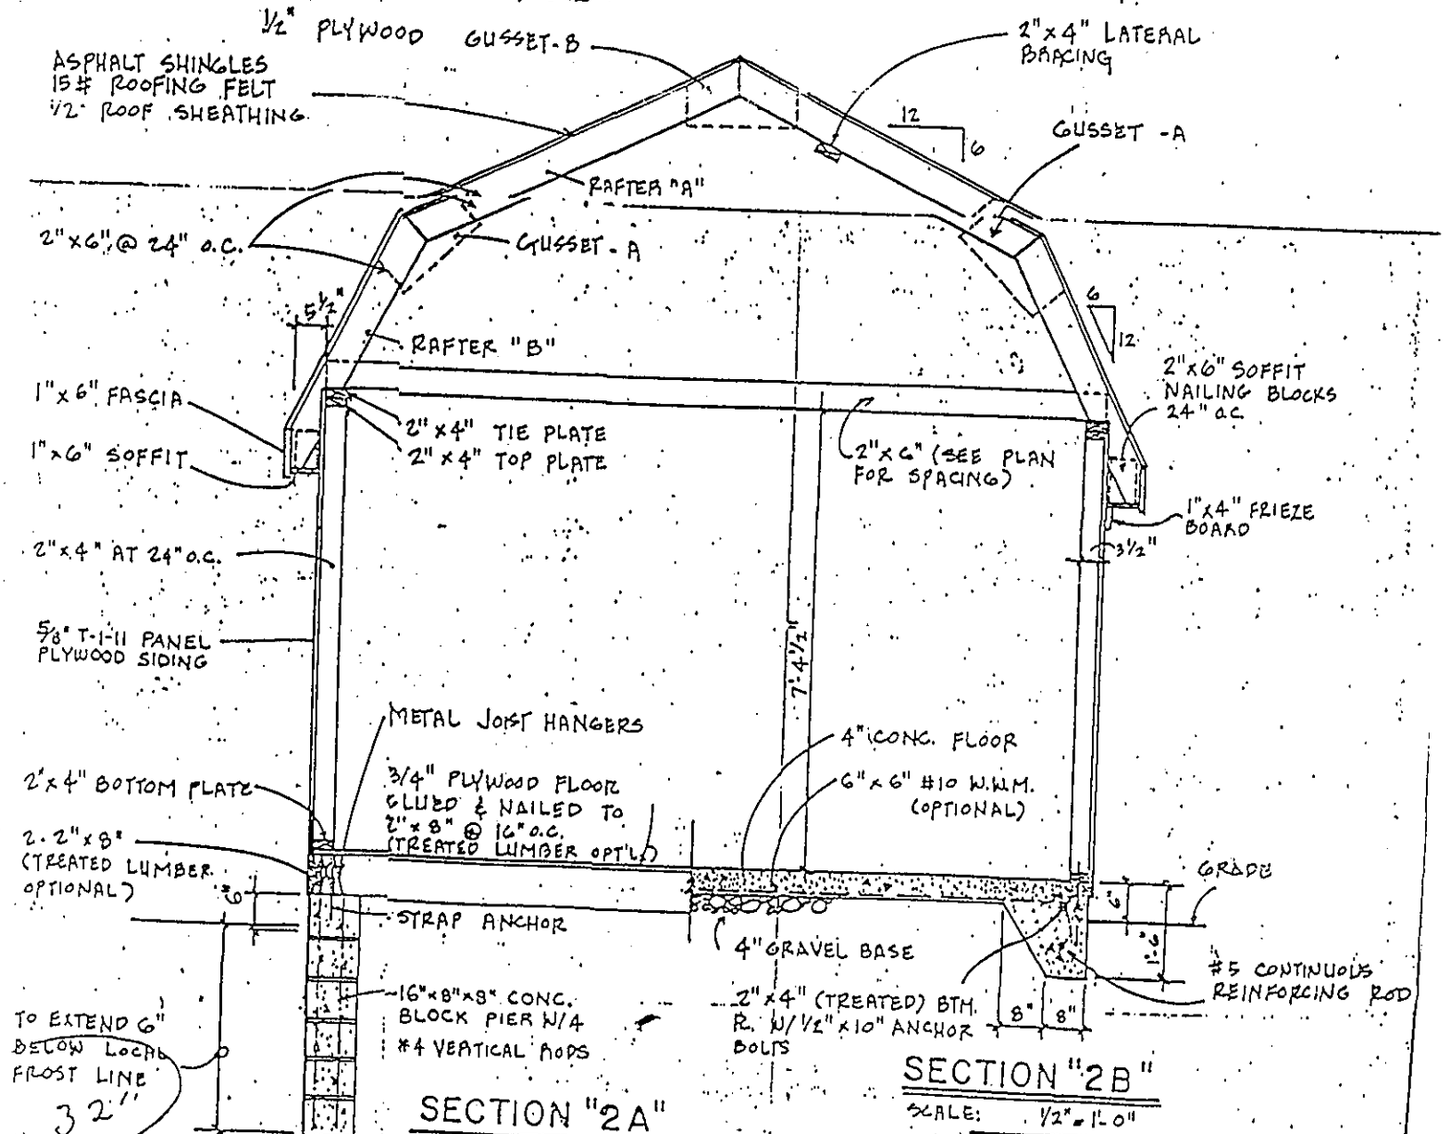

SECTION "2A"

SCALE: 1/2" = 1'-0"

SECTION "2B"

SCALE: 1/2" = 1'-0"

9/85

B-2042

SHEET 2
TOTAL 5